

CERTIFICATION

We, the undersigned members of the Board of Zoning Commission of Granville Township, Mercer County, Ohio, by our signatures, certify that we have adopted a system of color codes for the Granville Township Zoning Map, and that the following color code will be used in the event of a zoning district being re-zoned.

1. A red line around the property indicates a Commercial Zone.
2. A black line around the property indicates an Industrial Zone.
3. Other zoning districts may become effective as lands are re-zoned, then those colors will be assigned.
4. The A1-R1 zoning district currently applies to all lands in Granville Township, and no color code is adopted for those lands.

Date: 5/26/94 Victor Moeder Board Member

Florence Evers
Edward Werhane
Walter R. Fortkamp
Harold Suwer

The Granville Township Zoning Commission certifies this to be a true copy of the zoning map of Granville Township, Mercer County Ohio, Dated this 5/27/94 of

Florence Evers
Secretary

5-11-94 James R. Greenwell Zoning Inspector

FILED
at 2:34 o'clock P. M

JUL 19 1994

Patricia E. Grote
RECORDER - MERCER, CO., OHIO

GRANVILLE TOWNSHIP

RANGE 2 E TOWN 7 S

SECTION 25

PLAT BOOK PAGE

SCALE 1" = 400'

The Granville Township Zoning Commission certifies this to be a true copy of the zoning map of Granville Township, Mercer County Ohio, Dated this 5-10-1994 of Normal Court

Secretary

FILED
at 2:34 o'clock P. M.


JUL 19 1994

RECORDER - MERCER CO., OHIO

*Zoned C-1
Commercial
June 14, 1994
Effective Date
of July 14, 1994 Per Ord 519-
Zoning Department
Granville Twp*



DATE OF MAP	TWP. <u>GRA</u> SEC. <u>25</u>
DATE OF REVISION	TOWN <u>7S</u> RGE. <u>2E</u>
DRAFTER	
SCALE: 1" = 400'	
<p>071-2500 MAP NUMBER</p>	

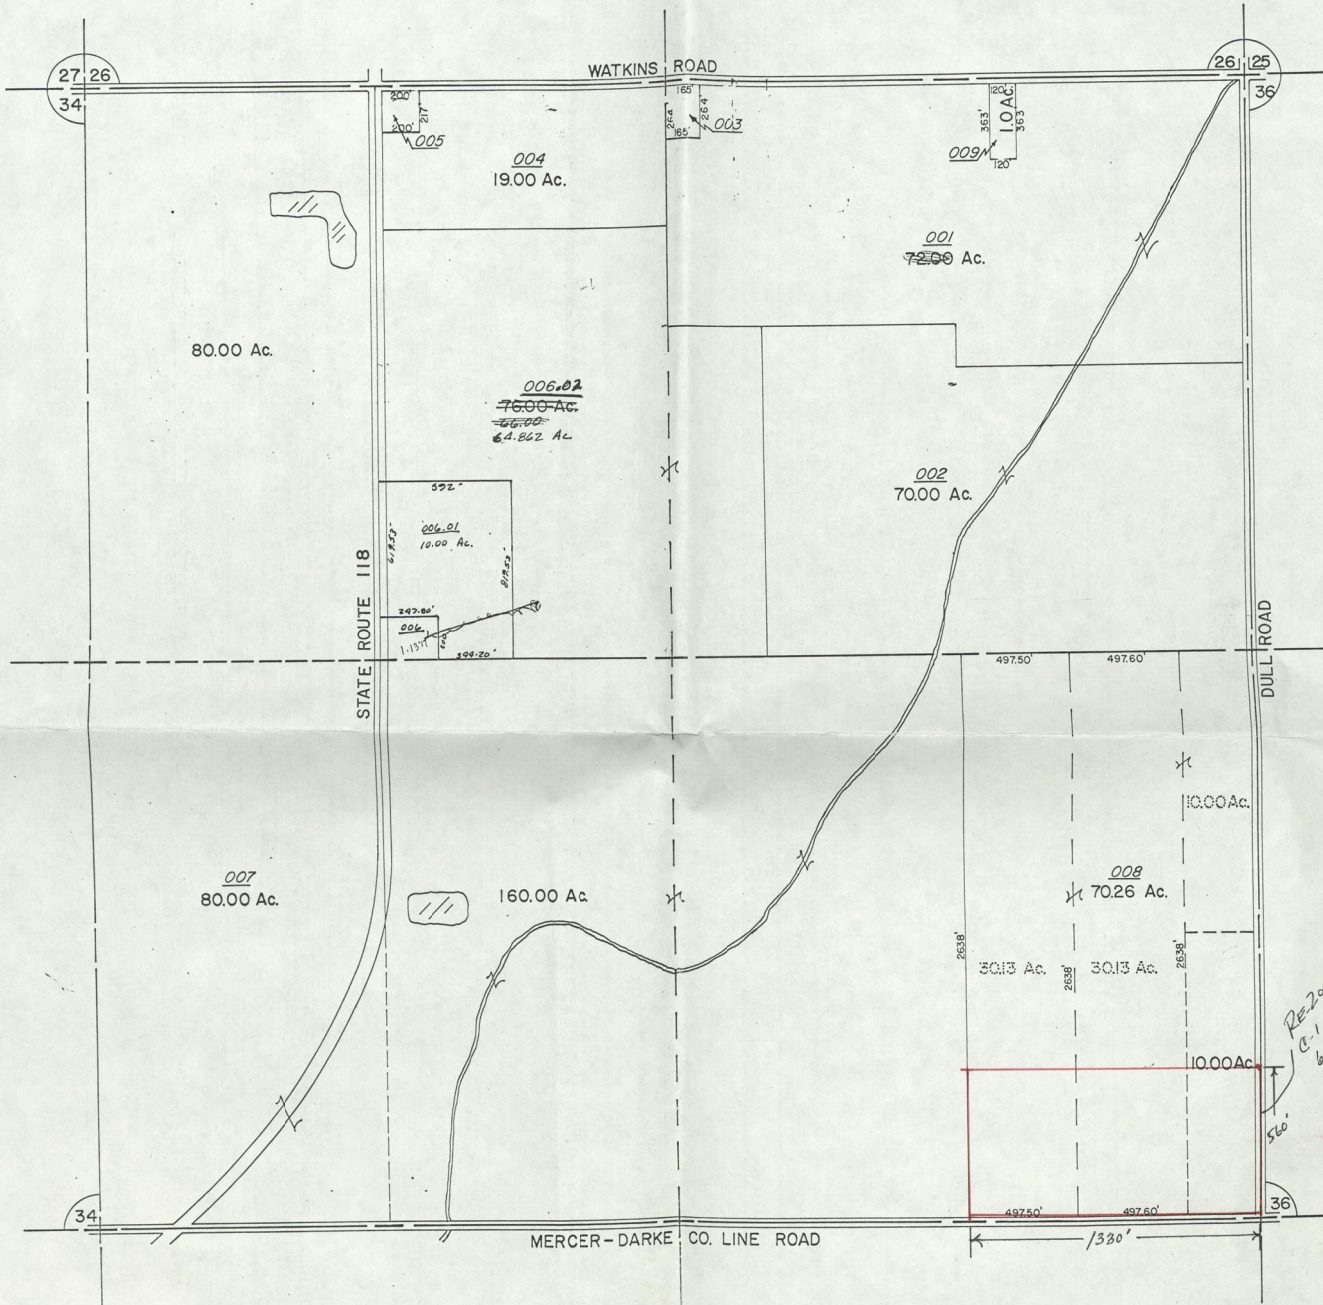

RE-Zoned From A-1 to
 C-1 Commercial on
 6-14-94. Effective
 DATE OF 7-14-94
 Zoning Commission
 Granville Township
 James P. [Signature]

DARKE COUNTY

FILED
at 2:34 o'clock P.M.

JUL 19 1994

Peterson E. [Signature]
RECORDER - MERCER, CO., OHIO

The Granville Township Zoning Commission certifies this to be a true copy of the zoning map of Granville Township, Mercer County Ohio, Dated this 5-10-1994 of [Signature]

Secretary

P.P. No. 072-3500-00-XXX.XX
KBM-84

GRANVILLE TOWNSHIP
TOWN 15 N RANGE 2 E
SCALE 1"=400' SECTION 35

PAGE 43